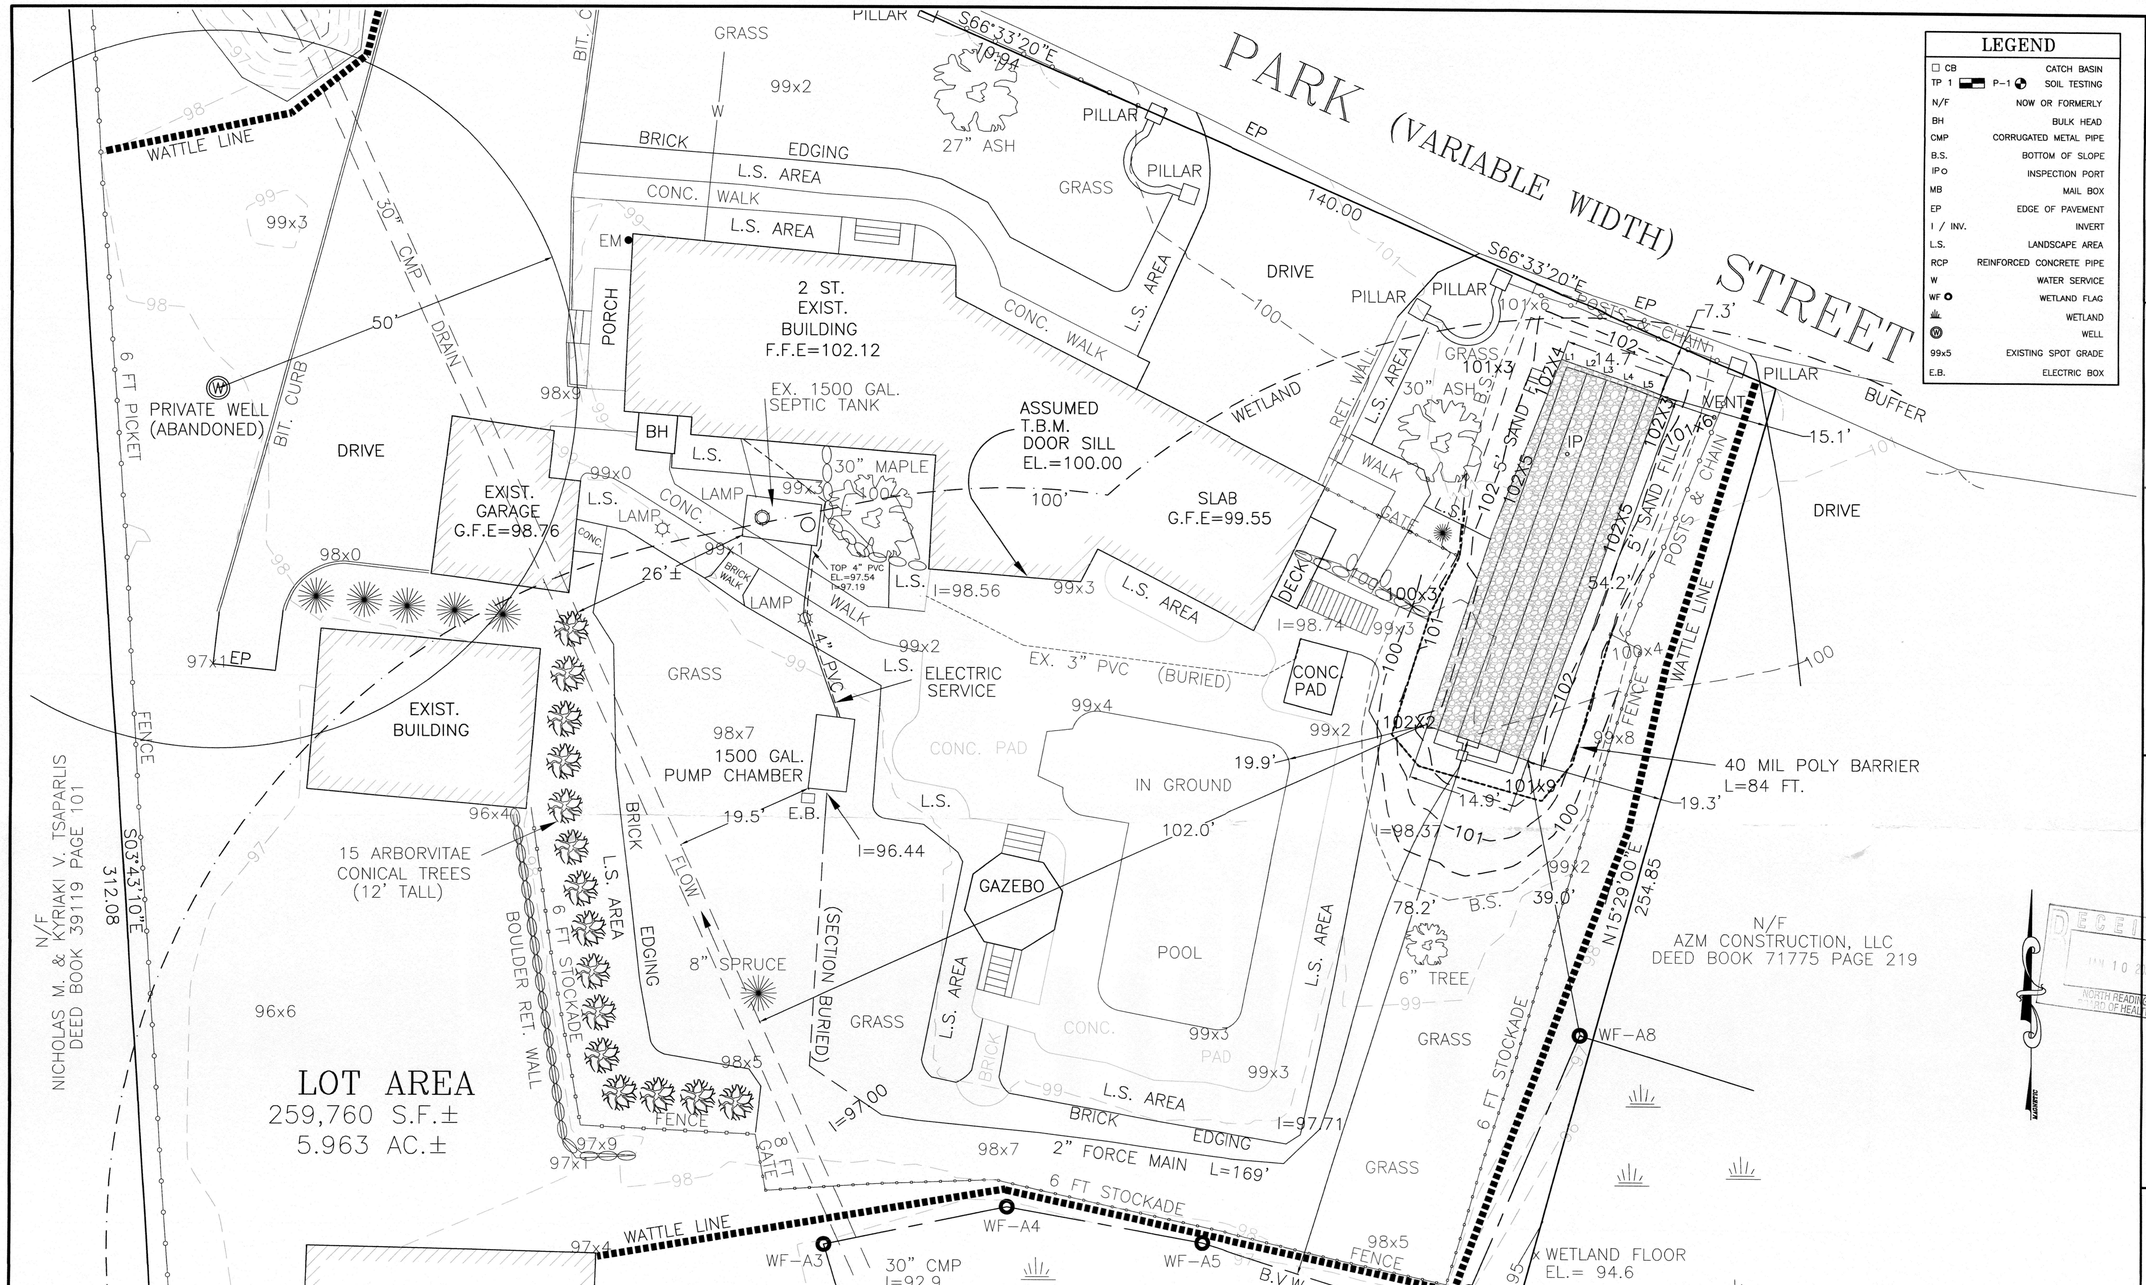

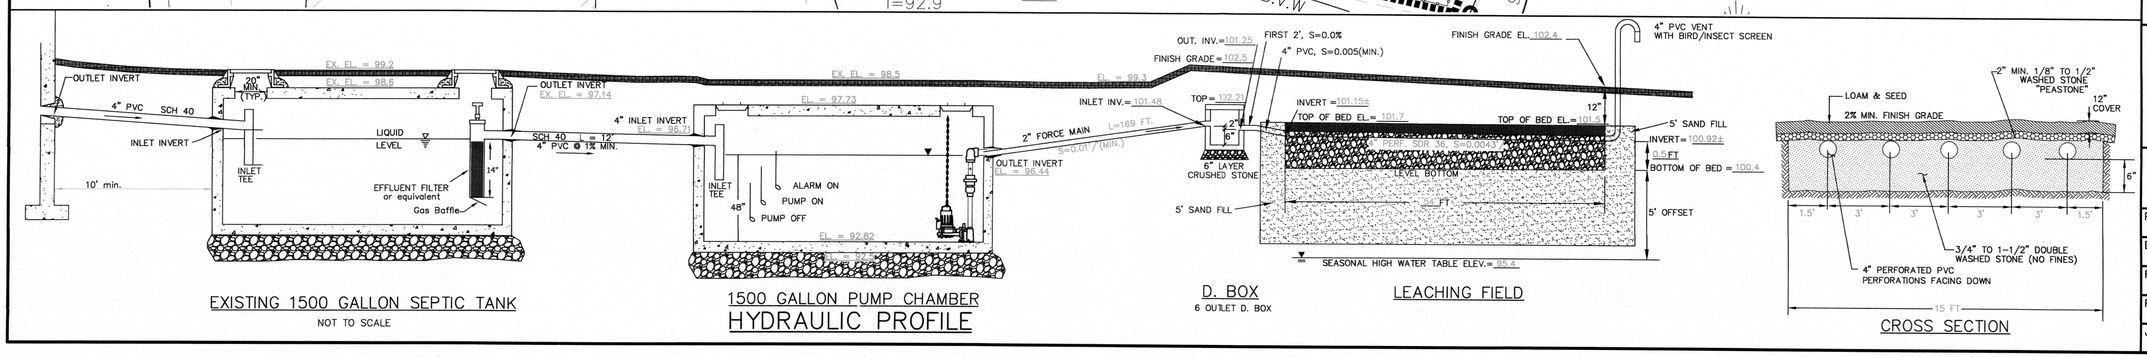

SEPTIC SYSTEM AS-BUILT PLAN FOR 74 PARK STREET NORTH READING MASSACHUSETTS

JANUARY 7, 2022

PREPARED FOR:

NORMAN AND LYNNE BROWN
123 PINECREST ROAD
LITCHFIELD, NH 03052

REVISIONS:

NO.	DATE	DESCRIPTION

SCALE: 1"=10'

FIELD: ERN	CALCULATED: ERN
DRAWN: ERN	CHECKED: ERN
FILE PATH (H:/PROJ): XXX	
FIELD BOOK/PAGE: 1/12-22	SHEET: 1 OF 1
JOB NO.: 2020_4	